

**946**  
S312890

**RICHARD ROAD**

**ENGINEER'S CERTIFICATION**  
 I, DARRYL HAYTER  
 being a Consulting Engineer and duly authorised representative of: -  
 EMPOWER ENGINEERS AND PROJECT MANAGERS  
 hereby:-  
 # certify the information contained in this drawing is an accurate "as constructed" representation of the works;  
 # accept responsibility for the "as constructed" information contained in this drawing; and  
 # acknowledge the "as constructed" information contained in the drawing may be relied on by the Moreton Bay Regional Council and others.  
 Certification for Stage 14 by *D.H.* on 22/08/17  
 For: EMPOWER ENGINEERS AND PROJECT MANAGERS RPEQ 5694

I, Peter Sippel being a cadastral surveyor and duly authorised representative of Queensland Surveying Pty Ltd hereby:  
 • certify the information contained in this drawing is an accurate as constructed representation of the works  
 • accept responsibility for the as constructed information contained in this drawing  
 • acknowledge the as constructed information contained in the drawing may be relied on by council and others  
 Certification by *P. Sippel* on 10/8/2017  
 (Signature) (Date)  
 for Queensland Surveying Pty Ltd

**LEGEND**

8.8 — AS CONSTRUCTED CONTOURS  
(Interval 0.2m)

— RETAINING WALL

DRAWING REVISIONS		REFERENCE DRAWINGS		DESIGN FILE No.	DESIGNED
REV.	REVISION DESCRIPTION	DRG. No.	DESCRIPTION	CONSTRUCT. No.	DATE
A	Original			30105-140100 AE	10/8/2017
				FIELD BOOK	DATE 10/8/2017
				LOG BOOK	CHECKED EJM
				LEVEL DATUM	DATE 10/8/2017
				DATUM	AHD PM177891

**THIS WORK WAS PREPARED BY:  
QUEENSLAND SURVEYING PTY LTD**




**MORETON BAY REGIONAL COUNCIL**  
 CABOOLTURE DISTRICT OFFICE  
 2 HASKING STREET CABOOLTURE QLD 4510  
 PO BOX 159 CABOOLTURE QLD 4510  
 Telephone: (07) 5433 0100  
 Fax: (07) 5433 4000

**STAGE 14, CAPESTONE  
AS CONSTRUCTED  
EARTHWORKS**

SCALE 1:500 ORIGINAL SIZE A1

MBRC SUBDIVISION REFERENCE	
DA/31223/2016/V23R	
No. 1 OF 2 PLANS	
DRAWING NUMBER	REV.
30105-140100 AE	A

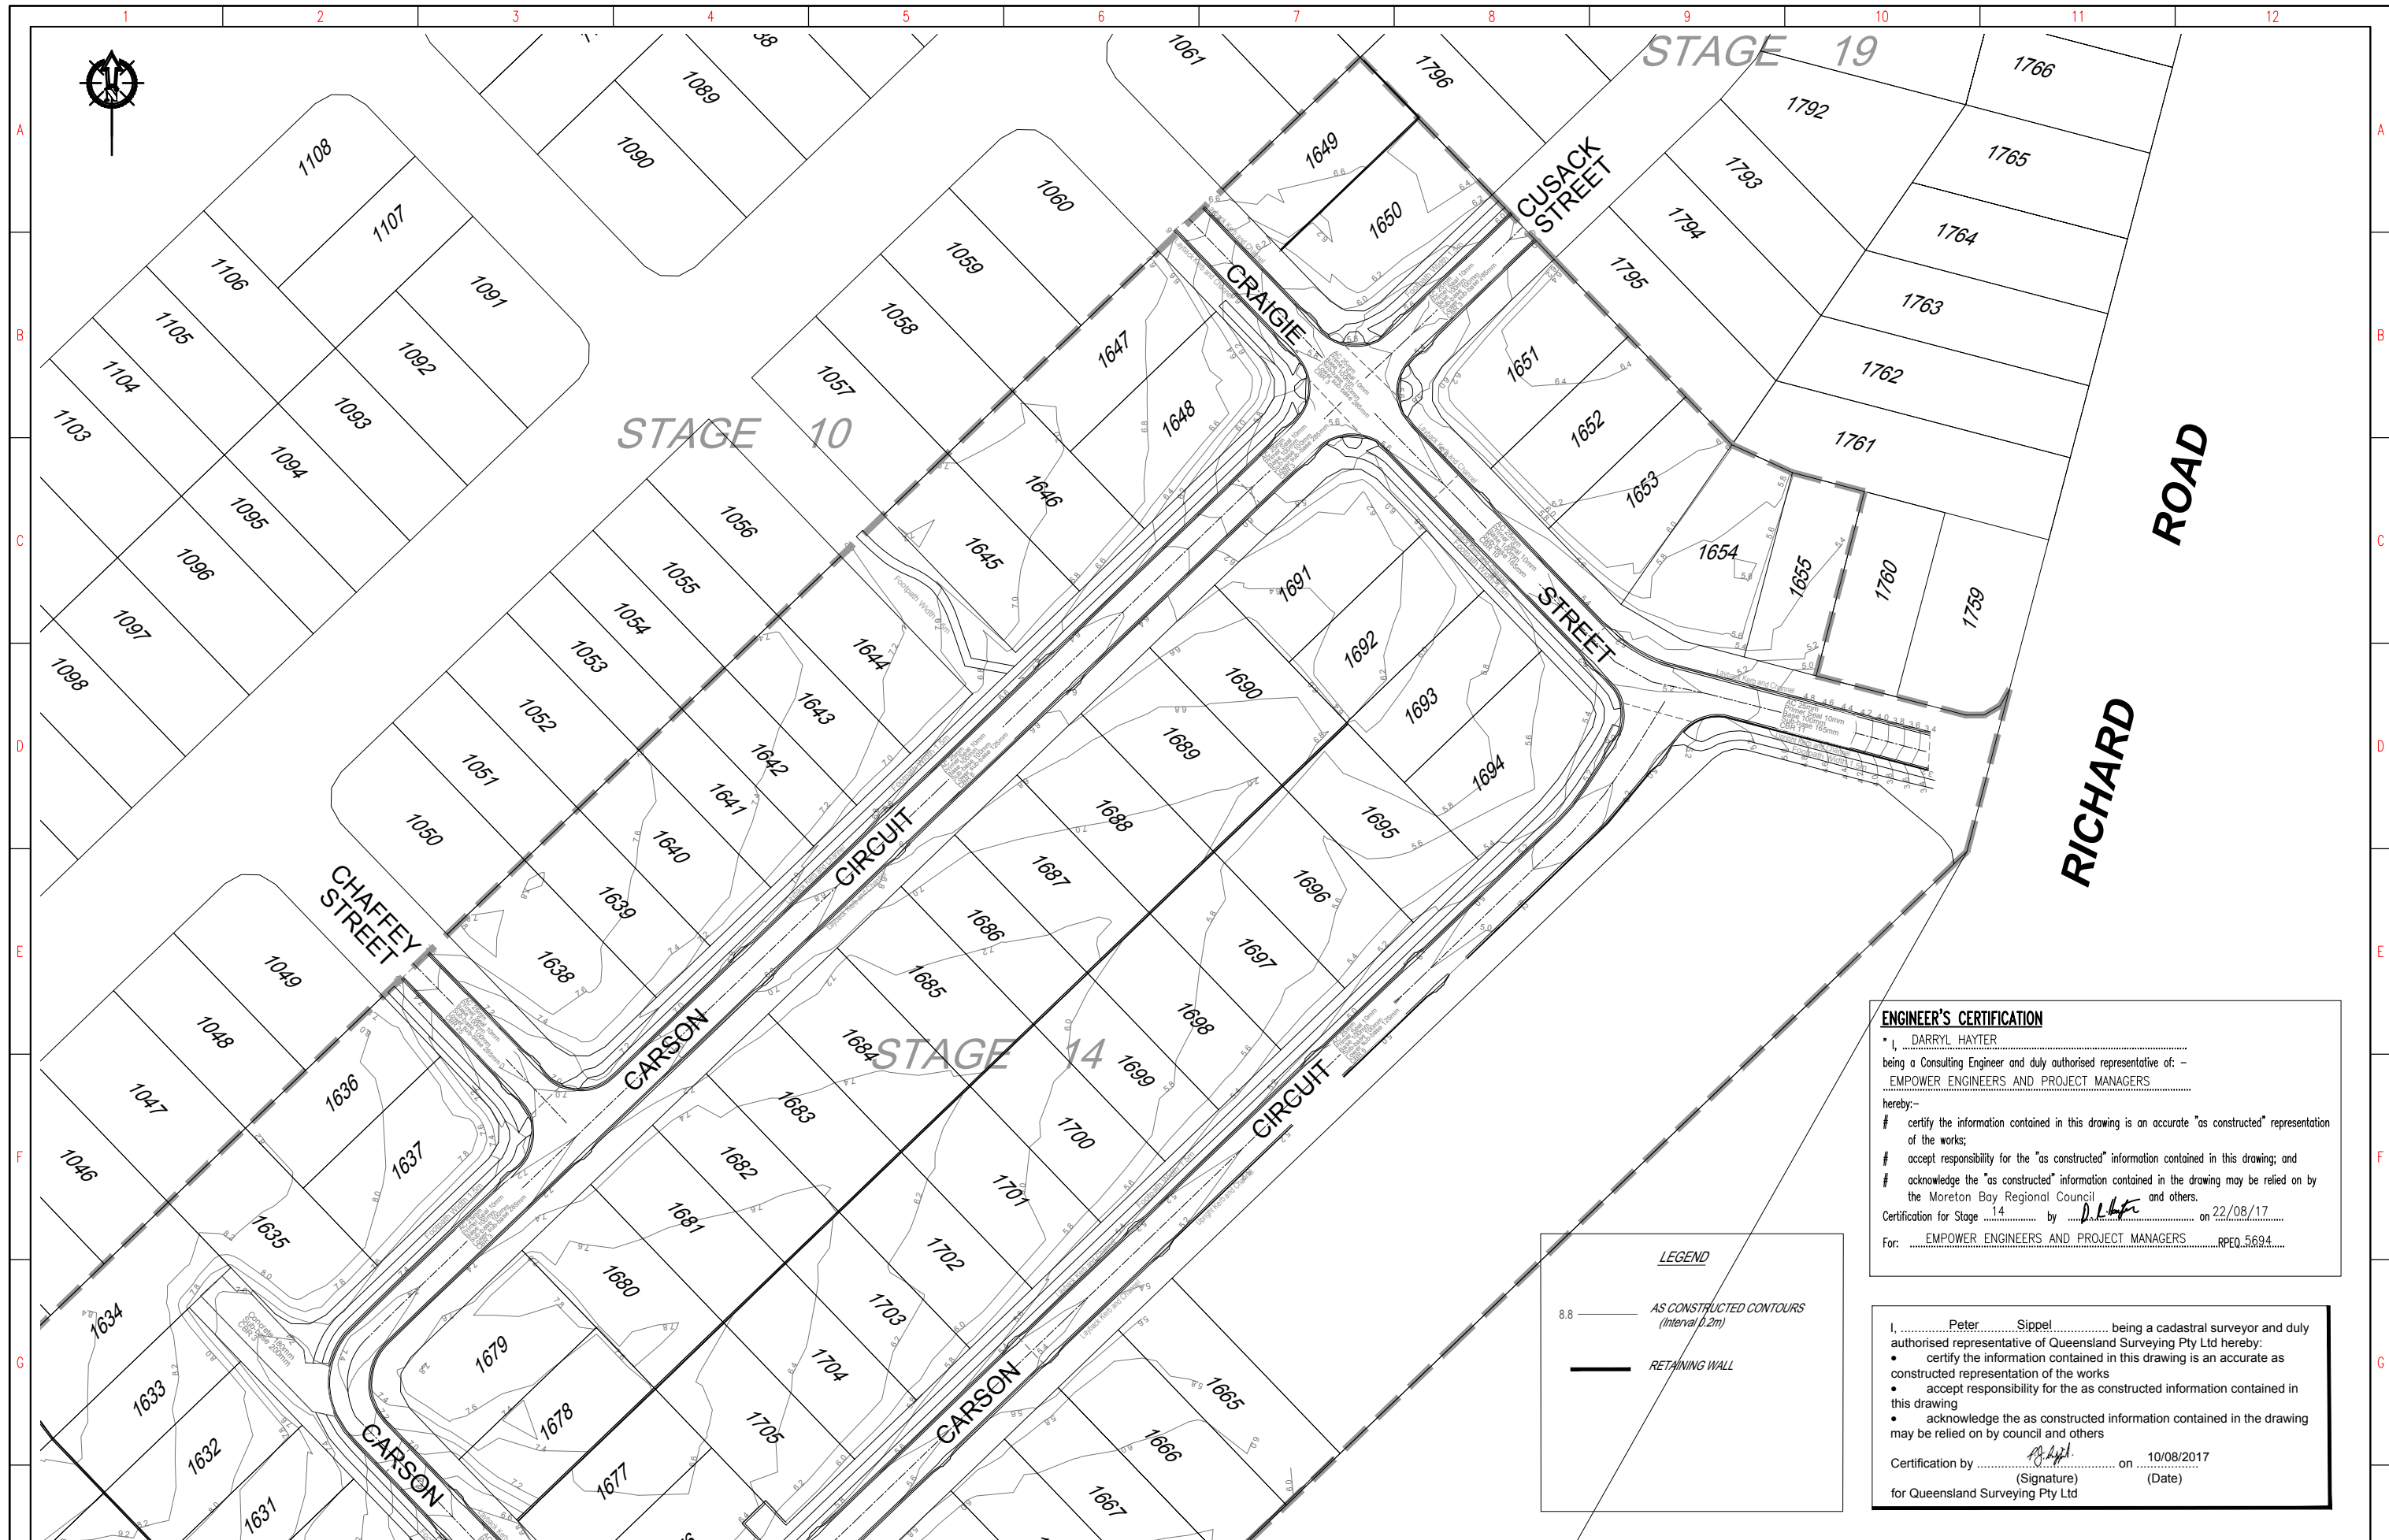

**ENGINEER'S CERTIFICATION**  
 I, DARRYL HAYTER  
 being a Consulting Engineer and duly authorised representative of: -  
EMPOWER ENGINEERS AND PROJECT MANAGERS  
 hereby:-  
 # certify the information contained in this drawing is an accurate "as constructed" representation of the works;  
 # accept responsibility for the "as constructed" information contained in this drawing; and  
 # acknowledge the "as constructed" information contained in the drawing may be relied on by the Moreton Bay Regional Council and others.  
 Certification for Stage 14 by D.H. on 22/08/17  
 For: EMPOWER ENGINEERS AND PROJECT MANAGERS RPE0 5694

I, Peter Sippel being a cadastral surveyor and duly authorised representative of Queensland Surveying Pty Ltd hereby:  
 • certify the information contained in this drawing is an accurate as constructed representation of the works  
 • accept responsibility for the as constructed information contained in this drawing  
 • acknowledge the as constructed information contained in the drawing may be relied on by council and others  
 Certification by P.S. on 10/08/2017  
 (Signature) (Date)  
 for Queensland Surveying Pty Ltd

**LEGEND**  
 8.8 — AS CONSTRUCTED CONTOURS (Interval 0.2m)  
 ——— RETAINING WALL

DRAWING REVISIONS		REFERENCE DRAWINGS		DESIGN FILE No.	DESIGNED
REV.	REVISION DESCRIPTION	DRG. No.	DESCRIPTION	CONSTRUCT. No.	DATE
A	Original			30105-140100 AE	10/8/2017
				FIELD BOOK	DATE
				LOG BOOK	CHECKED
				LEVEL DATUM	DATE
				DATUM	

**THIS WORK WAS PREPARED BY:  
 QUEENSLAND SURVEYING PTY LTD**



**MORETON BAY REGIONAL COUNCIL**  
 CABOOLTURE DISTRICT OFFICE  
 2 HASKING STREET CABOOLTURE QLD 4510  
 PO BOX 159 CABOOLTURE QLD 4510  
 Telephone: (07) 5433 0100  
 Fax: (07) 5433 4000

**STAGE 14, CAPESTONE  
 AS CONSTRUCTED  
 EARTHWORKS**

MBRC SUBDIVISION REFERENCE	
DA/31223/2016/V23R	
No. 2 OF 2 PLANS	
DRAWING NUMBER	REV.
30105-140100 AE	A

SCALE 1:500 ORIGINAL SIZE A1