



REGISTERED SURVEYORS CERTIFICATION
 We, Queensland Surveying Pty Ltd (ACN 604 974 374) Coastal Surveyors, hereby certify that the vertical and horizontal locations and dimensions shown on this plan are a true and correct record and were located by survey.
 Date: 7/4/16
 Registration ID: 6152
 Delegate (signature): [Signature]
 Date: 7/4/16

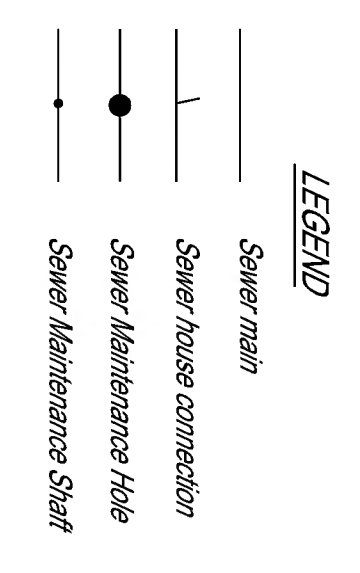

AS-CONSTRUCTED CERTIFICATION
 I, [Signature], hereby certify that the information contained in this drawing is in accordance with approved drawings and design. This represents an accurate record of as constructed works and I accept responsibility for the information contained in this drawing/document.

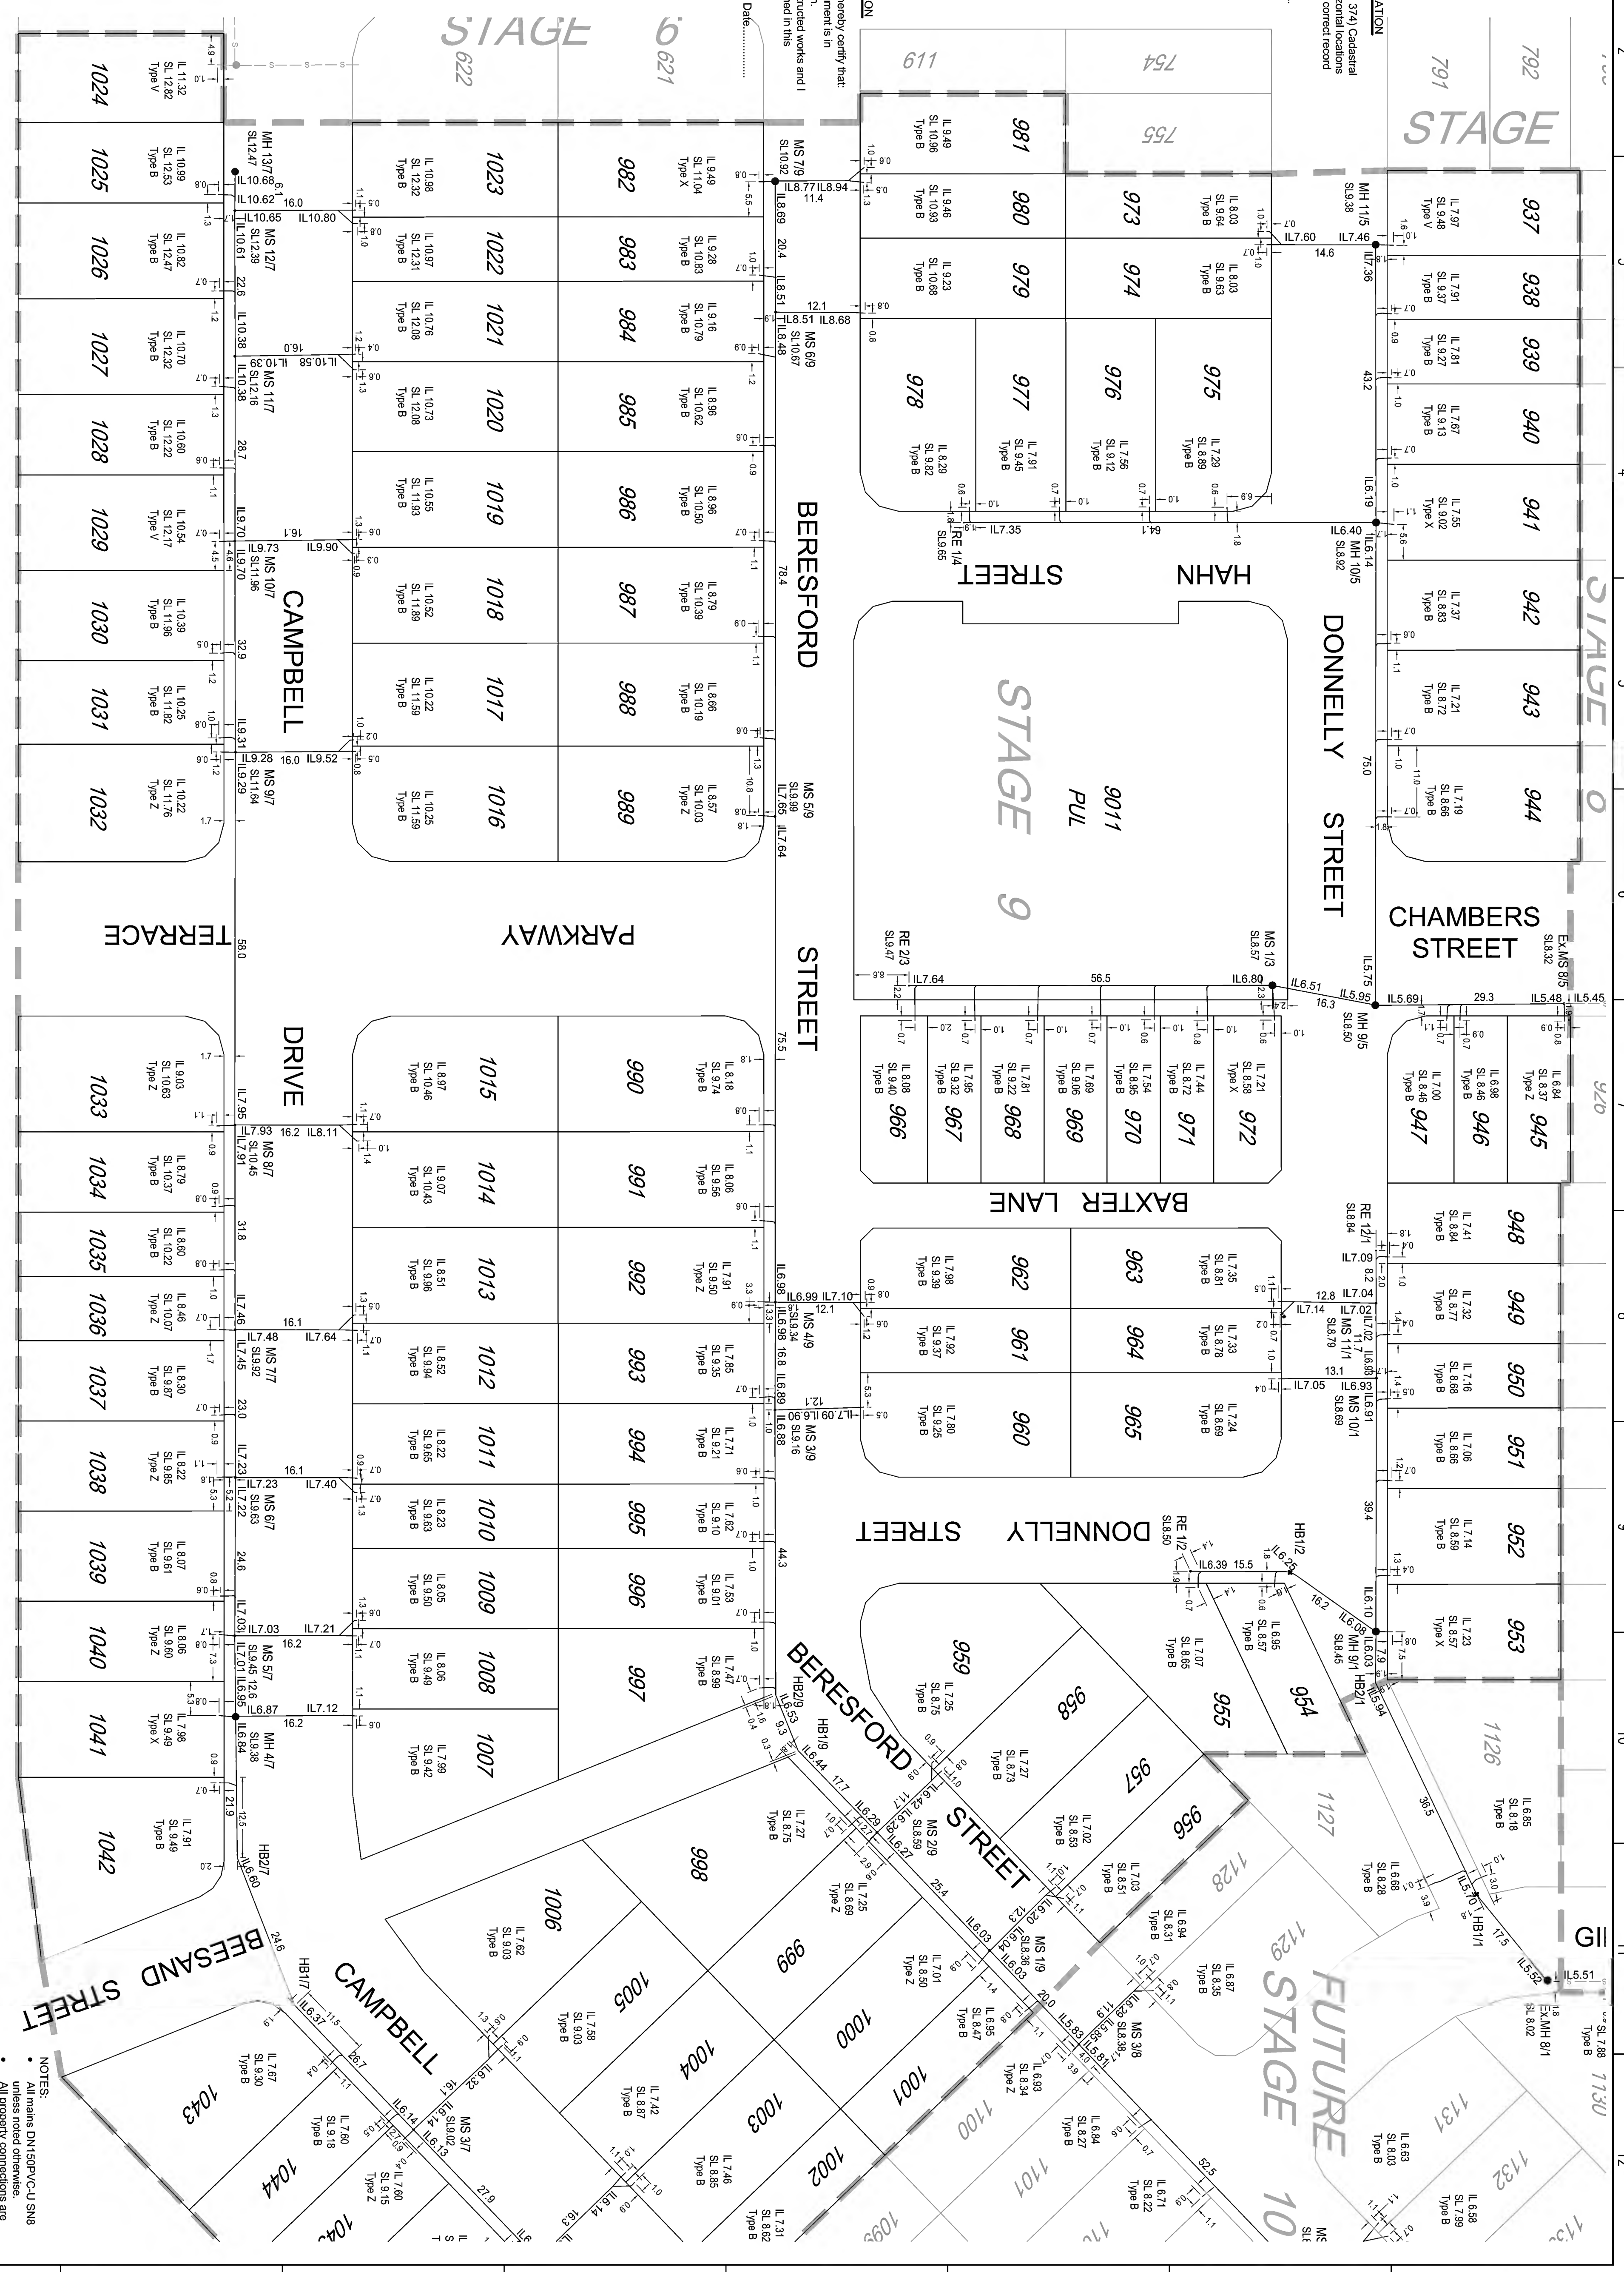

NOTES:
 • All mains DN150PVC-U S18
 • All manholes DN150PVC-U S18
 • All manholes DN100PVC-U S18

DRAWING REVISIONS		REFERENCE DRAWINGS		DESIGNED		CHECKED		DATE	
REV.	REVISION DESCRIPTION	DRG. No.	DESCRIPTION	CONSTRUCT. No.	DESIGN FILE No.	DATE	DATE	DATE	DATE
G	Original				0005-09000 AS	7/4/16	7/4/16	EM	
H	Amend lot 1041 HC					7/4/16	7/4/16	EM	

DRAWING REVISIONS		REFERENCE DRAWINGS		DESIGNED		CHECKED		DATE	
REV.	REVISION DESCRIPTION	DRG. No.	DESCRIPTION	CONSTRUCT. No.	DESIGN FILE No.	DATE	DATE	DATE	DATE
1		2		3		4		5	
6		7		8		9		10	
11		12							

THIS WORK WAS PREPARED BY:
QUEENSLAND SURVEYING PTY LTD



MORRISON BAY REGIONAL COUNCIL
 CABOOTSURF DISTRICT OFFICE
 2 HASKING STREET CABOOTSURF QLD 4510
 Telephone: (07) 5433 0100
 Fax: (07) 5433 4000

STAGE 9, CAPESTONE AS CONSTRUCTED SEWERAGE RETICULATION

DRAWING REVISIONS		REFERENCE DRAWINGS		DESIGNED		CHECKED		DATE	
REV.	REVISION DESCRIPTION	DRG. No.	DESCRIPTION	CONSTRUCT. No.	DESIGN FILE No.	DATE	DATE	DATE	DATE
1		2		3		4		5	
6		7		8		9		10	
11		12							

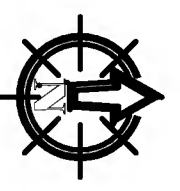

- NOTES:
- All mains DN150PVC-U S/N8 unless noted otherwise.
 - All property connections are DN100 PVC-U


REGISTERED SURVEYORS CERTIFICATION

We, Queensland Surveying Pty Ltd (ACN 604 671 374) Cadastral Surveyors, hereby certify that the vertical and horizontal locations and dimensions shown on this plan are a true and correct record and were located by survey.

Delegated (signature) *[Signature]* Registration ID 6152 Date 7/4/16

AS-CONSTRUCTED CERTIFICATION

- I, *[Signature]* hereby certify that:
- The information contained in this drawing/document is in compliance with approved drawings and design.
 - This represents an accurate record of as constructed works and I accept responsibility for the information contained in this drawing/document.
- RPEQ (signature) *[Signature]* RPEQ No. *[Number]* Date *[Date]*

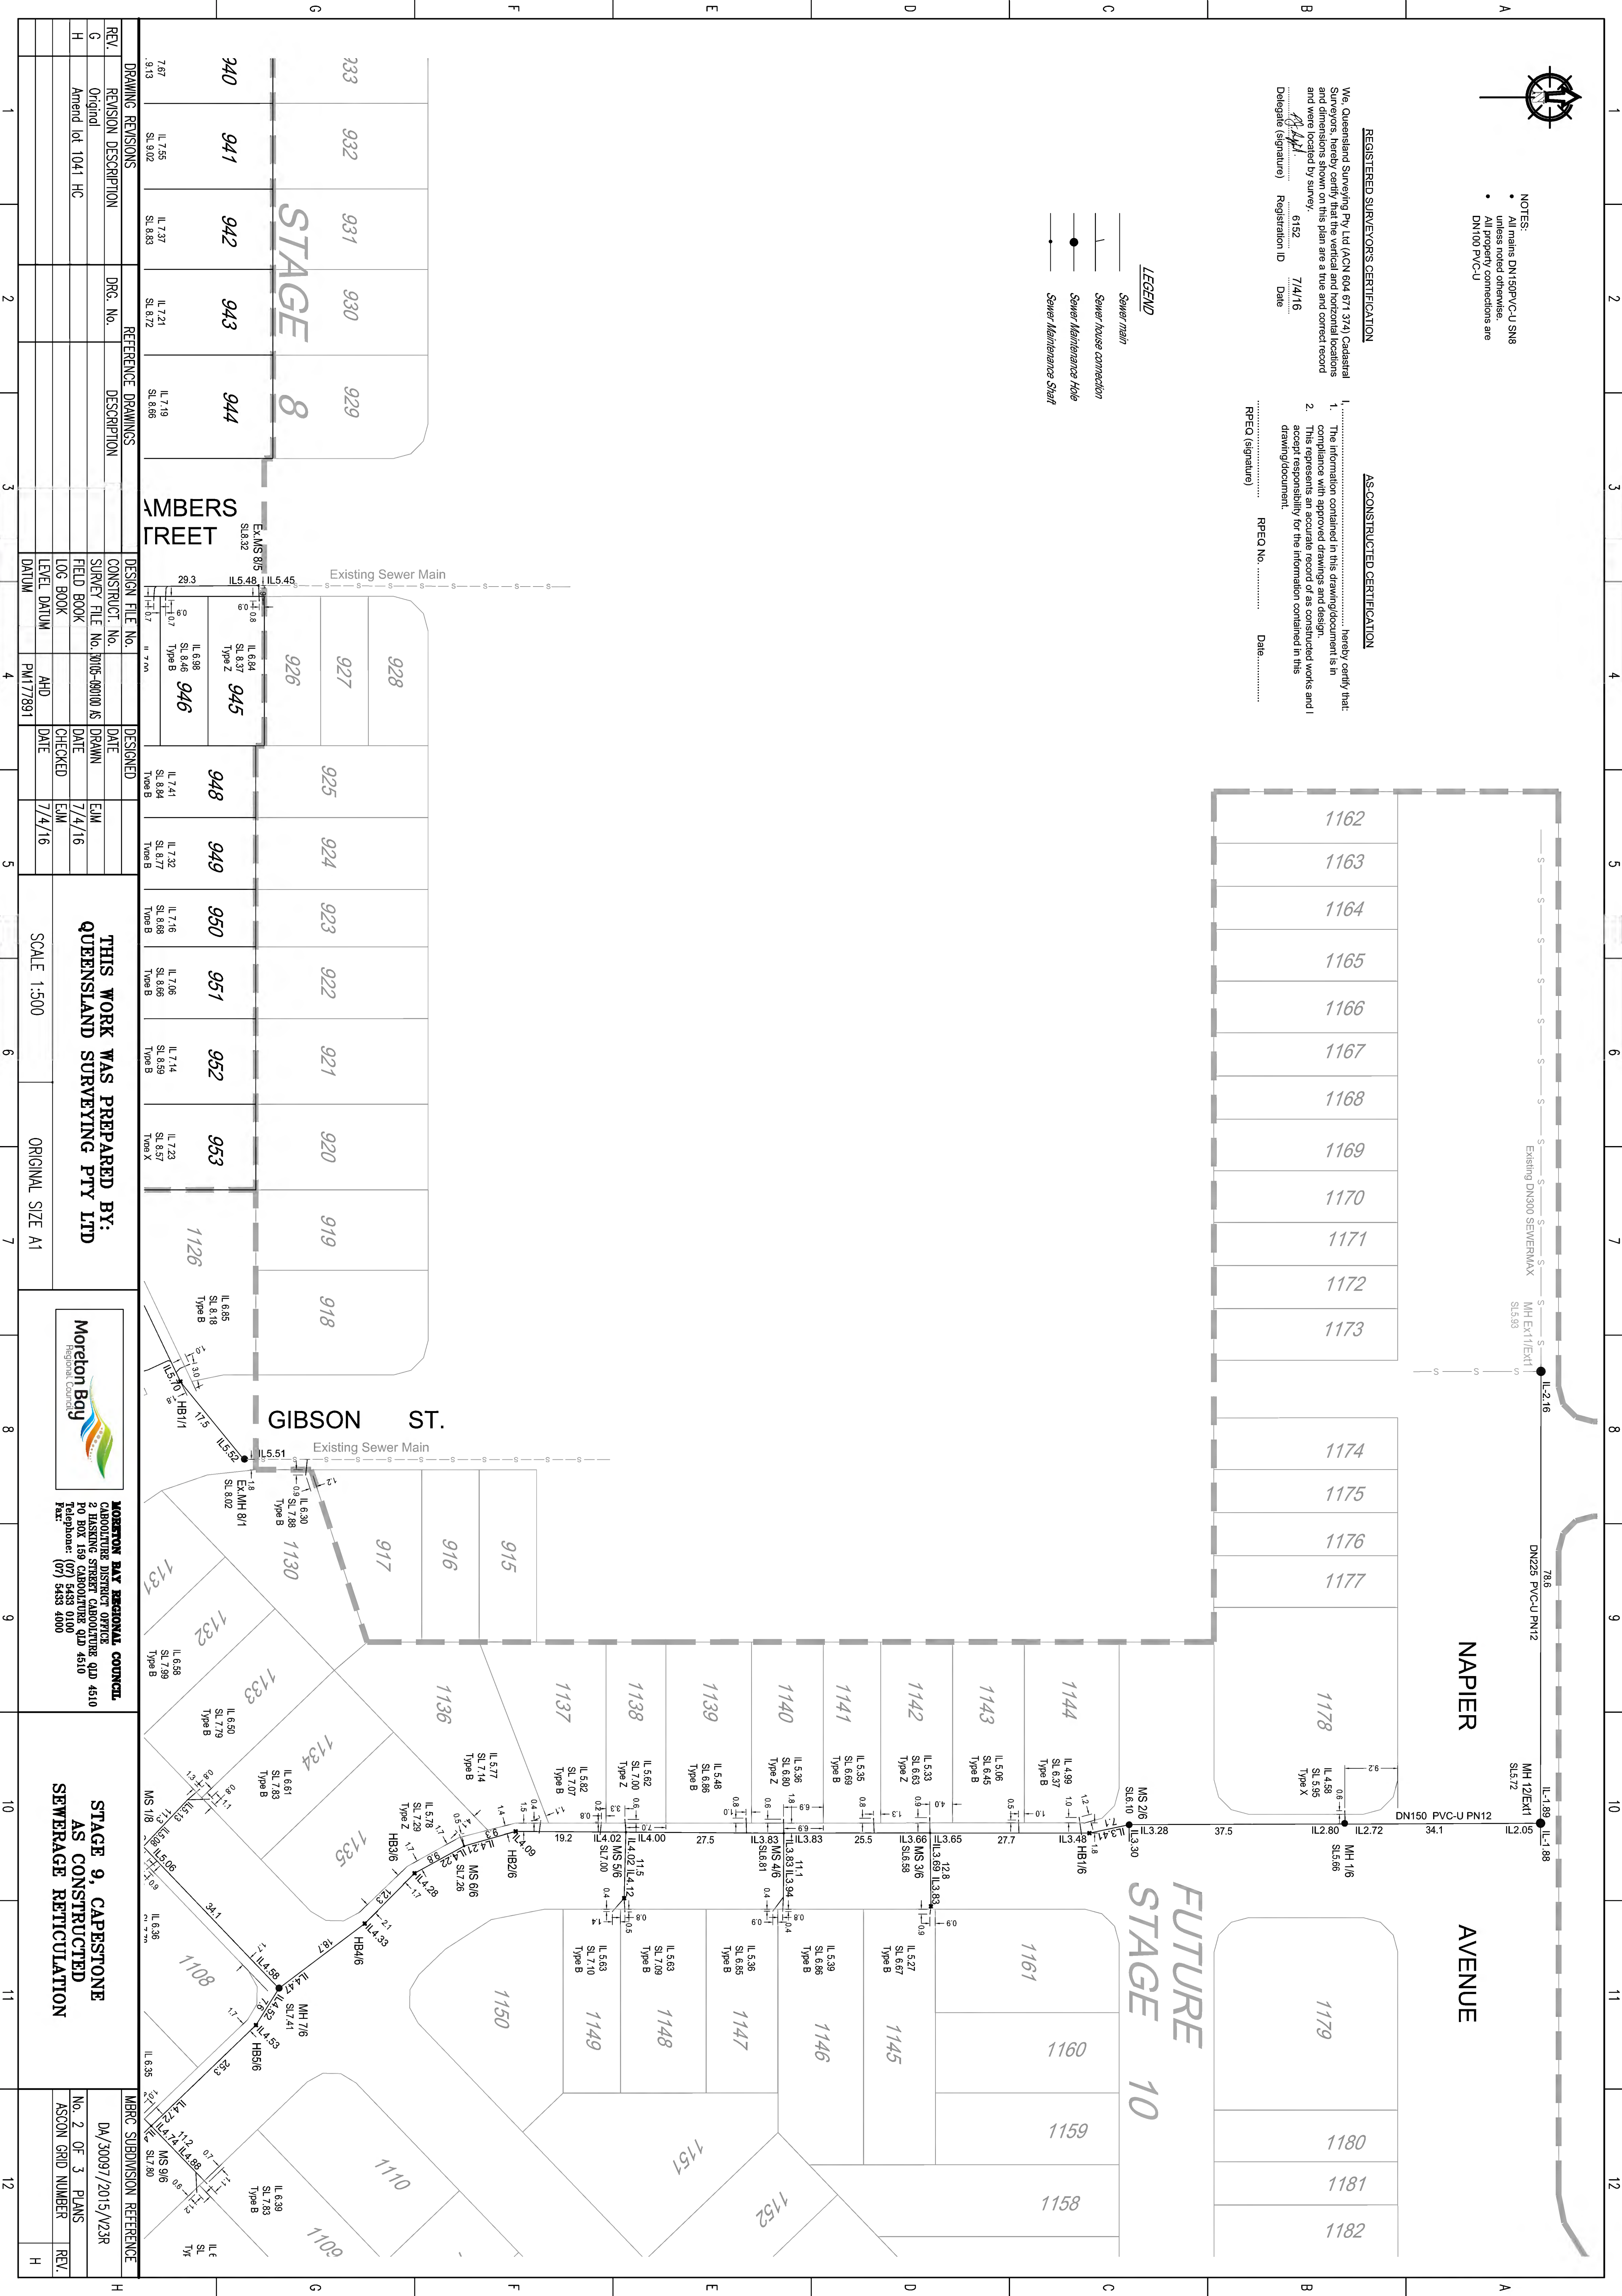

REV.	REVISION DESCRIPTION	DRG. No.	DESCRIPTION
G	Original		
H	Amend lot 1041 HC		

DESIGNED	DATE	DESIGNED	DATE
EJM	7/4/16		
EJM	7/4/16		

THIS WORK WAS PREPARED BY:
QUEENSLAND SURVEYING PTY LTD
 SCALE 1:500 ORIGINAL SIZE A1

THIS WORK WAS PREPARED BY:
QUEENSLAND SURVEYING PTY LTD
 SCALE 1:500 ORIGINAL SIZE A1

NO. 2 OF 3 PLANS	NO. 2 OF 3 PLANS
DA/30097/2015/V23R	DA/30097/2015/V23R
ASCON GRID NUMBER	ASCON GRID NUMBER
REV.	REV.

REV.	REVISION DESCRIPTION	DRG. No.	DESCRIPTION
G	Original		
H	Amend lot 1041 HC		

DESIGNED	DATE	DESIGNED	DATE
EJM	7/4/16		
EJM	7/4/16		

THIS WORK WAS PREPARED BY:
QUEENSLAND SURVEYING PTY LTD
 SCALE 1:500 ORIGINAL SIZE A1

THIS WORK WAS PREPARED BY:
QUEENSLAND SURVEYING PTY LTD
 SCALE 1:500 ORIGINAL SIZE A1

NO. 2 OF 3 PLANS	NO. 2 OF 3 PLANS
DA/30097/2015/V23R	DA/30097/2015/V23R
ASCON GRID NUMBER	ASCON GRID NUMBER
REV.	REV.

NO. 2 OF 3 PLANS	NO. 2 OF 3 PLANS
DA/30097/2015/V23R	DA/30097/2015/V23R
ASCON GRID NUMBER	ASCON GRID NUMBER
REV.	REV.

