




I, Peter Sippel being a cadastral surveyor and duly authorised representative of THG WSG Pty Ltd hereby:

- certify the information contained in this drawing is an accurate as constructed representation of the works
- accept responsibility for the as constructed information contained in this drawing
- acknowledge the as constructed information contained in the drawing may be relied on by council and others

Certification of Stage 4 by [Signature] on 27/10/14
 for THG WSG Pty Ltd (Signature) (Date)

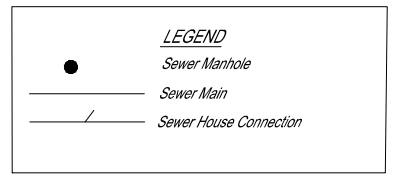

ENGINEER'S CERTIFICATION

I, David Polden being a Consulting Engineer and duly authorised representative of: - BMD Consulting hereby:-

- certify the information contained in this drawing is an accurate "as constructed" representation of the works;
- accept responsibility for the "as constructed" information contained in this drawing; and
- acknowledge the "as constructed" information contained in the drawing may be relied on by the Moreton Bay Regional Council and others.

Certification for Stage 4 by [Signature] on 25.11.14
 For: BMD CONSULTING Pty. Ltd. RPEQ.....1907.....

46187



DRAWING REVISIONS		REFERENCE DRAWINGS		DESIGN FILE No.	DESIGNED
REV.	REVISION DESCRIPTION	DRG. No.	DESCRIPTION	CONSTRUCT. No.	DATE
A	Original				
B	Update				
C	Add HC SLs				

SURVEY FILE No.	DATE	DRAWN	CHECKED
247404_9 AS	27/10/14	EJM	EJM
FIELD BOOK			
LOG BOOK			
LEVEL DATUM	AHD		
DATUM	PM137449		


THIS WORK WAS PREPARED BY:
THG WSG PTY LTD

SCALE 1:500 ORIGINAL SIZE A1

MORETON BAY REGIONAL COUNCIL
 CABOOLTURE DISTRICT OFFICE
 2 HASKING STREET CABOOLTURE QLD 4510
 PO BOX 159 CABOOLTURE QLD 4510
 Telephone: (07) 5433 0100
 Fax: (07) 5433 4000

STAGE 4 CAPESTONE AS CONSTRUCTED SEWER RETICULATION

MBRC SUBDIVISION REFERENCE	
DA/27987/2013/V23R	
No. 1 OF 3 PLANS	REV.
ASCAN GRID NUMBER	
46187	C

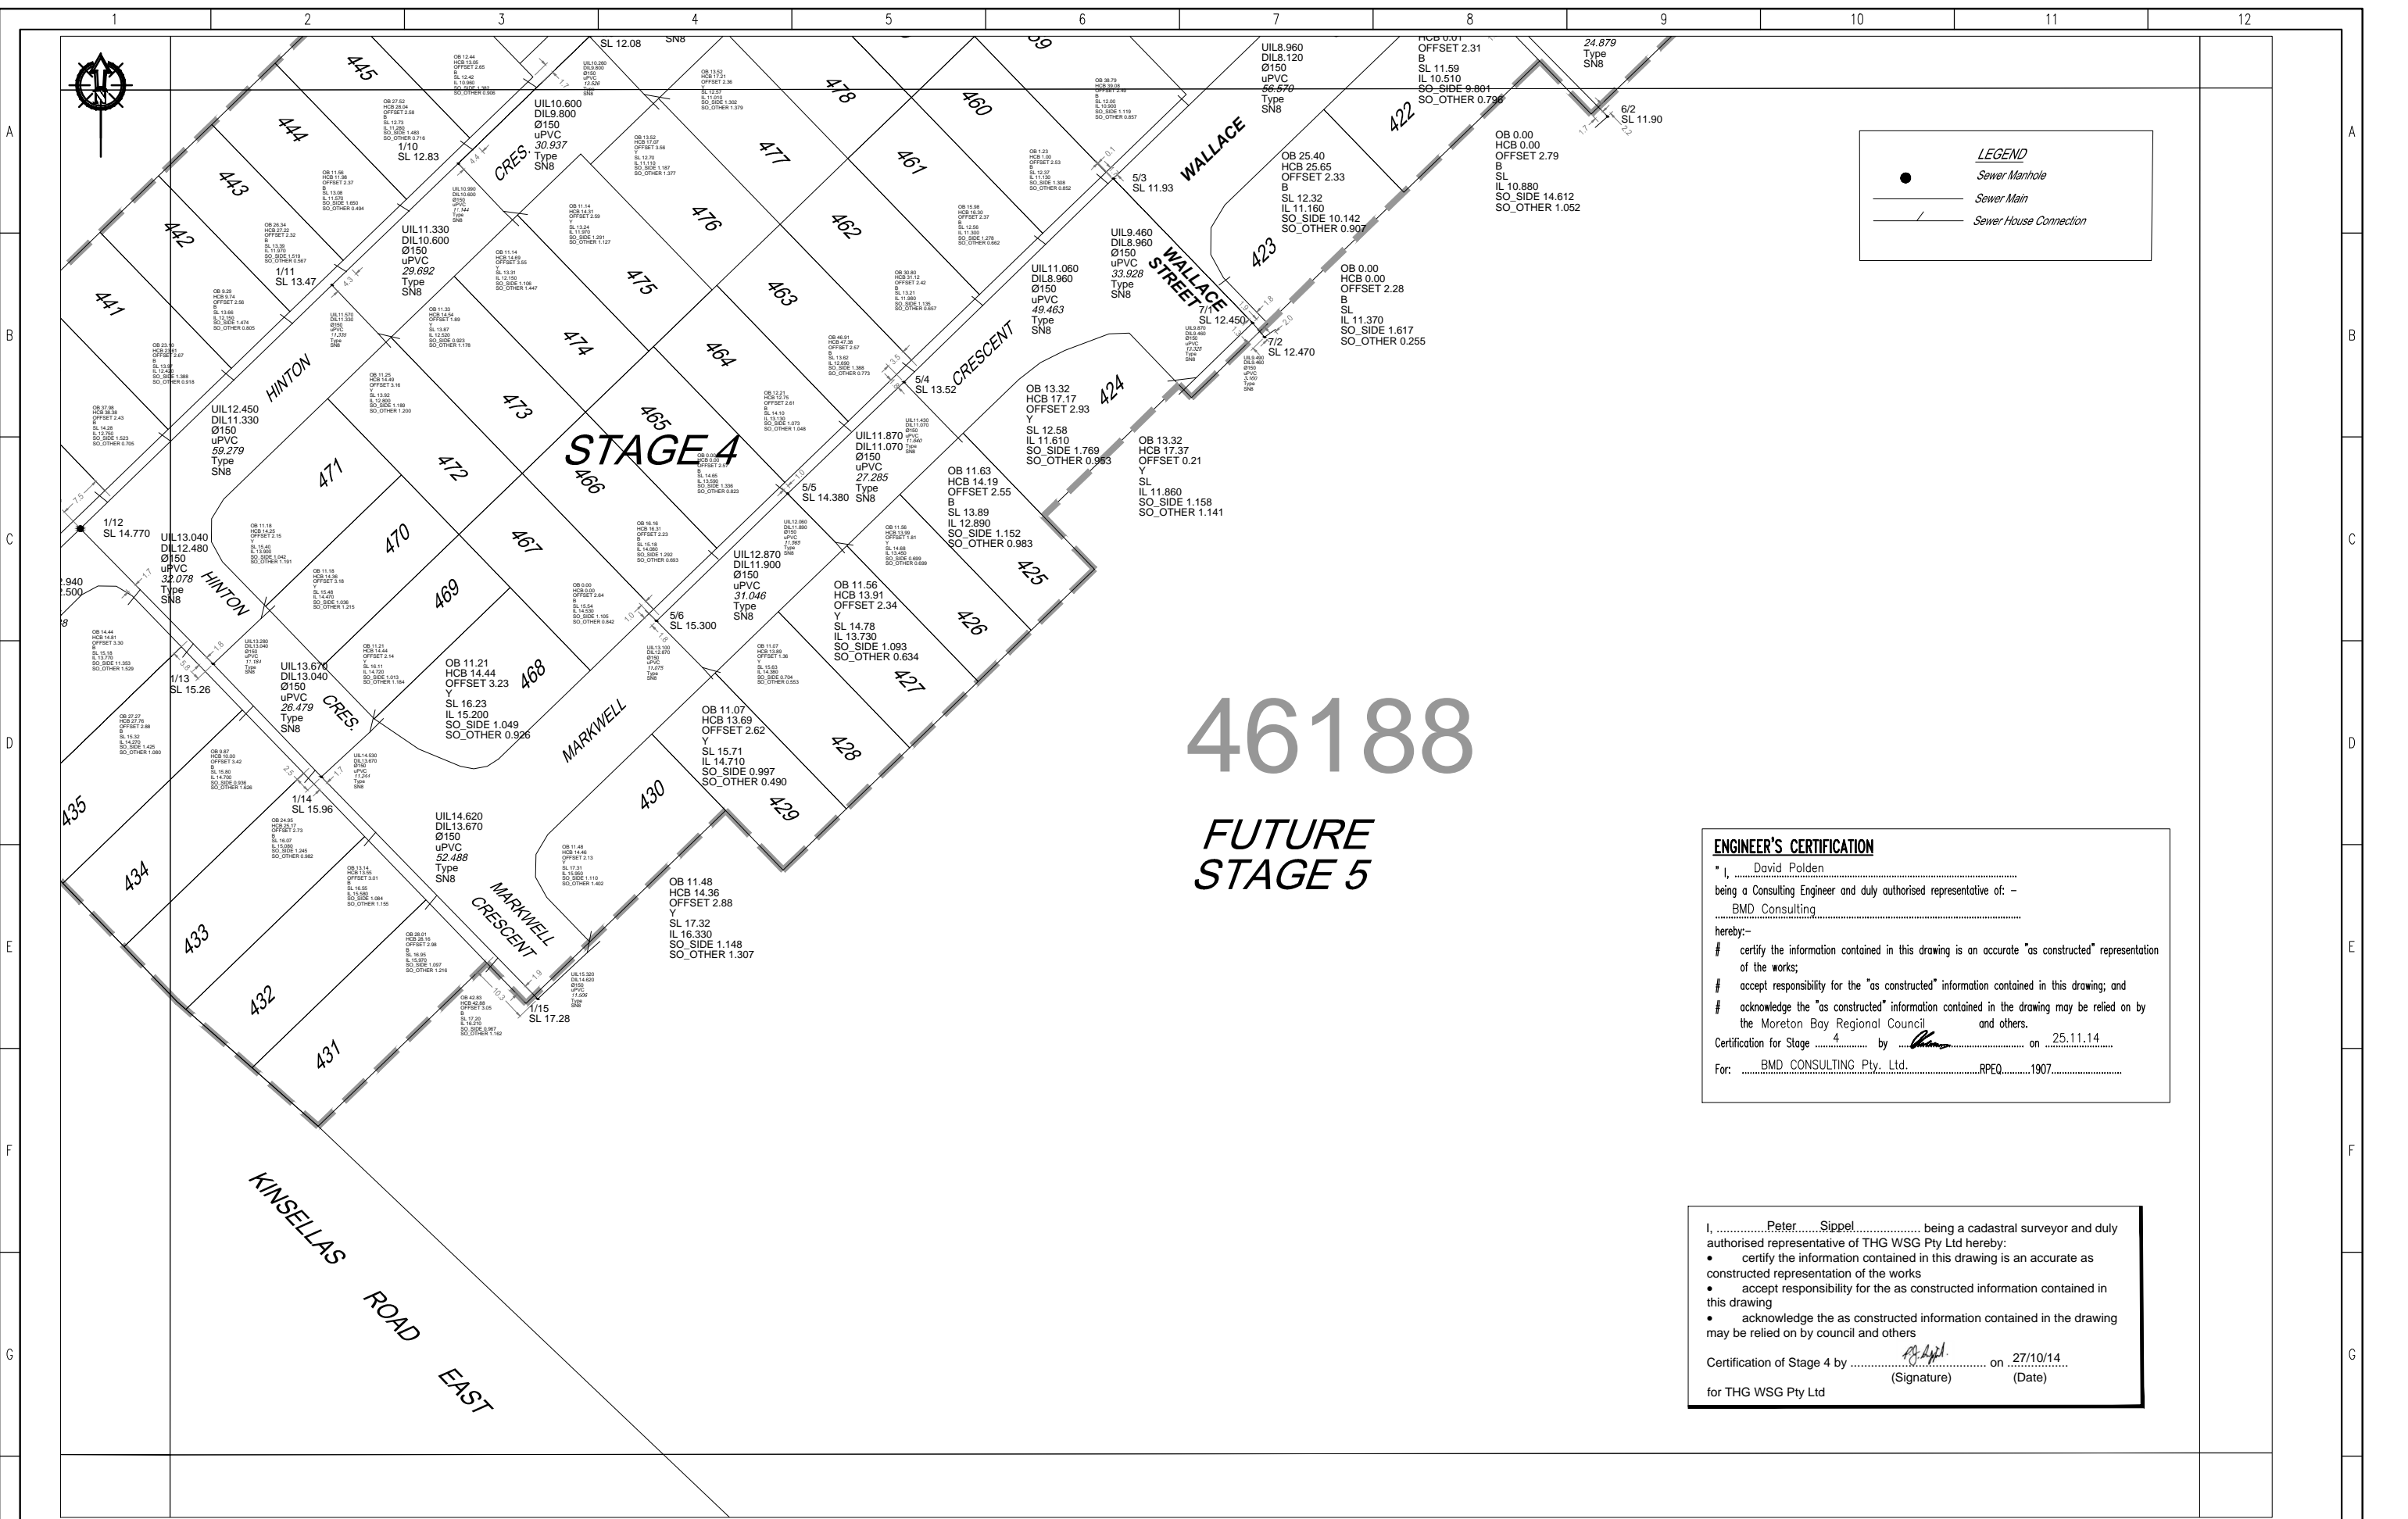

LEGEND

- Sewer Manhole
- Sewer Main
- /— Sewer House Connection

ENGINEER'S CERTIFICATION

I, David Polden being a Consulting Engineer and duly authorised representative of: BMD Consulting hereby:-

- # certify the information contained in this drawing is an accurate "as constructed" representation of the works;
- # accept responsibility for the "as constructed" information contained in this drawing; and
- # acknowledge the "as constructed" information contained in the drawing may be relied on by the Moreton Bay Regional Council and others.

Certification for Stage 4 by [Signature] on 25.11.14

For: BMD CONSULTING Pty. Ltd. RPEQ 1907

I, Peter Sippel being a cadastral surveyor and duly authorised representative of THG WSG Pty Ltd hereby:

- certify the information contained in this drawing is an accurate as constructed representation of the works
- accept responsibility for the as constructed information contained in this drawing
- acknowledge the as constructed information contained in the drawing may be relied on by council and others

Certification of Stage 4 by [Signature] on 27/10/14 for THG WSG Pty Ltd (Date)

DRAWING REVISIONS		REFERENCE DRAWINGS		DESIGN FILE No.	DESIGNED
REV.	REVISION DESCRIPTION	DRG. No.	DESCRIPTION	CONSTRUCT. No.	DATE
A	Original				
B	Update				
C	Add HC SLs				

DESIGNED	DATE	CHECKED	DATE
EJM	27/10/14	EJM	27/10/14

THIS WORK WAS PREPARED BY:
THG WSG PTY LTD

SCALE 1:500 ORIGINAL SIZE A1

MORETON BAY REGIONAL COUNCIL
 CABOOLTURE DISTRICT OFFICE
 2 HASKING STREET CABOOLTURE QLD 4510
 PO BOX 159 CABOOLTURE QLD 4510
 Telephone: (07) 5433 0100
 Fax: (07) 5433 4000

STAGE 4 CAPESTONE AS CONSTRUCTED SEWER RETICULATION		MBRC SUBDIVISION REFERENCE	
		DA/27987/2013/V23R	
		No. 1 OF 3 PLANS	
		ASCAN GRID NUMBER	REV.
		46188	C