



ENGINEER'S CERTIFICATION
 I, DARRYL HAYTER
 being a Consulting Engineer and duly authorised representative of:
 Empower Engineers & Project Managers
 hereby:-
 certify the information contained in this drawing is an accurate "as constructed" representation of the works;
 accept responsibility for the "as constructed" information contained in this drawing; and
 acknowledge the "as constructed" information contained in the drawing may be relied on by the Moreton Bay Regional Council and others.
 Certification for Stage 20A by D.H. on 28/06/18
 For: Empower Engineers & Project Managers RPEQ 5694

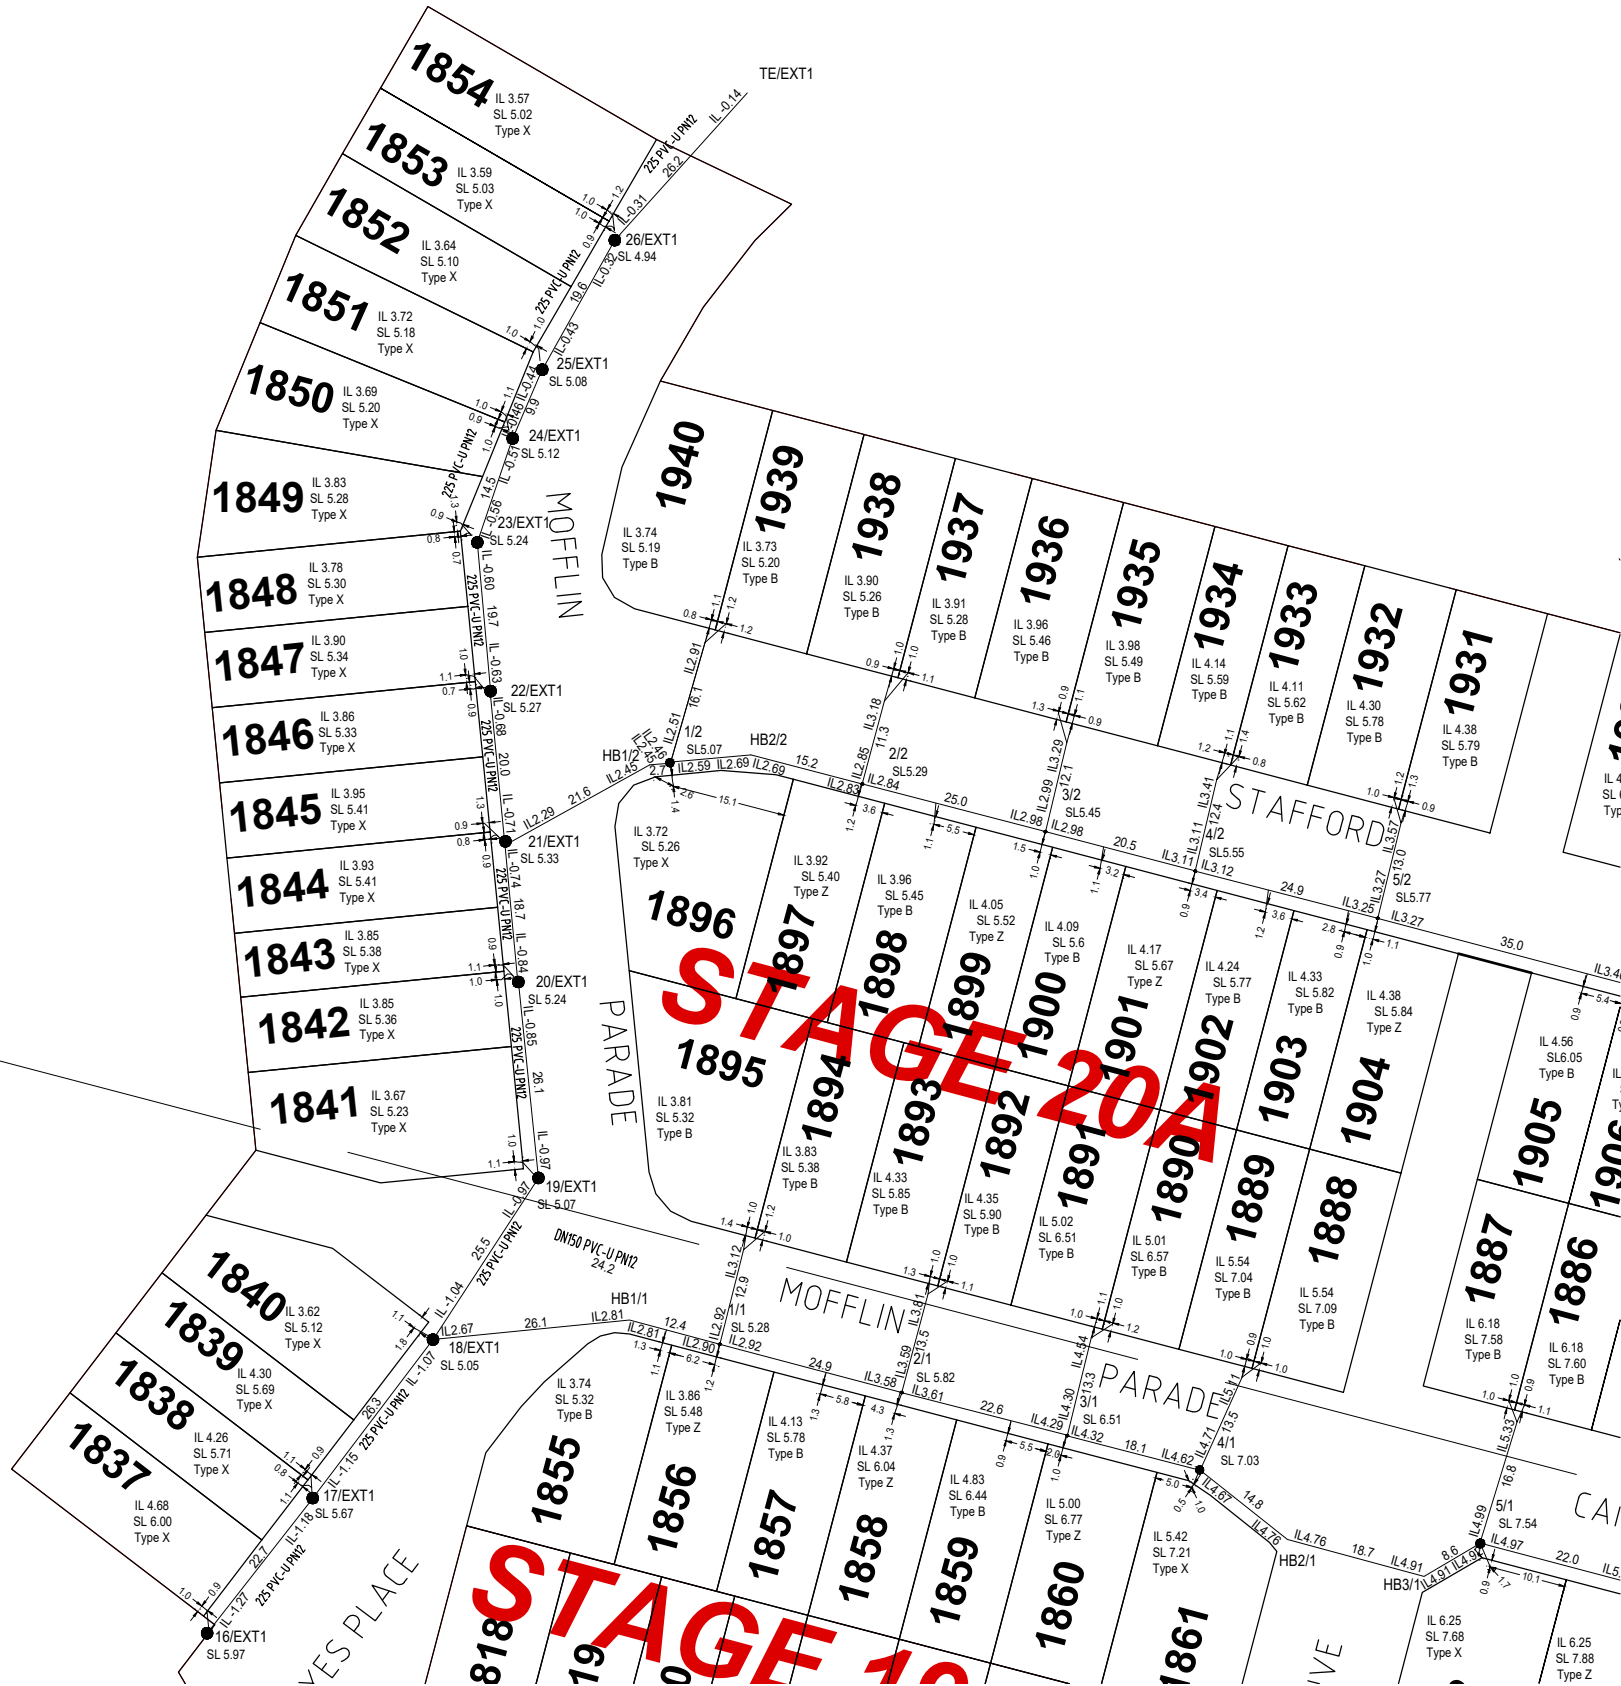


Registered Surveyor's certification
 We, QUEENSLAND SURVEYING PTY LTD, hereby certify that the vertical and horizontal locations, and dimensions shown on this plan are a true and correct record and were located by survey.
 Delegate Cadastral Surveyor 6152 21/06/2018 Date

- NOTES:**
- All new mains DN150 PVC-U SDR unless noted otherwise.
 - All property connections are DN100 PVC-U

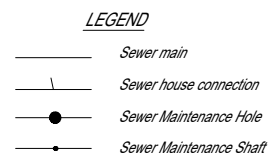

COORDINATE DATUM NOTE:
 HORIZONTAL COORDINATES(E,N) SUPPLIED ARE MAPPING GRID OF AUSTRALIA(MGA), ZONE 56 BASED ON THE UNIVERSAL TRANSVERSE MERCATOR PROJECTION AND THE GEOCENTRIC DATUM OF AUSTRALIA 1994.
 HORIZONTAL DATUM DERIVED FROM PSM186710, E 503315 600, N 6987236.028.
 LEVELS SUPPLIED ARE ON THE AUSTRALIAN HEIGHT DATUM(AHD)
 LEVEL DATUM DERIVED FROM PSM177891 RL 16.396 (AHD)


A1	INDEX	DATE	REVISIONS	DRAWN	CHECKED	PASSED	DRAWN	INITIALS	DATE	 BRISBANE (07) 3086 4329 MACKAY (07) 4051 2911 CARNS (07) 4051 6722 veris.com.au ACN 804 671 374 Queensland Surveying Pty Ltd a Veris Company	 2017009844 STAGE 20A CAPESTONE ESTATE KINSELLES ROAD EAST, MANGO HILL AS-CONSTRUCTED SEWER	SHEET 1 OF 2 SHEETS	SCALE 1500
	A	21/06/2018	ORIGINAL	JMc	JMc		JMc	JMc	21/06/2018			REVISION A	DISCIPLINE CODE C
											DRAWING NO. U-2017-0408		

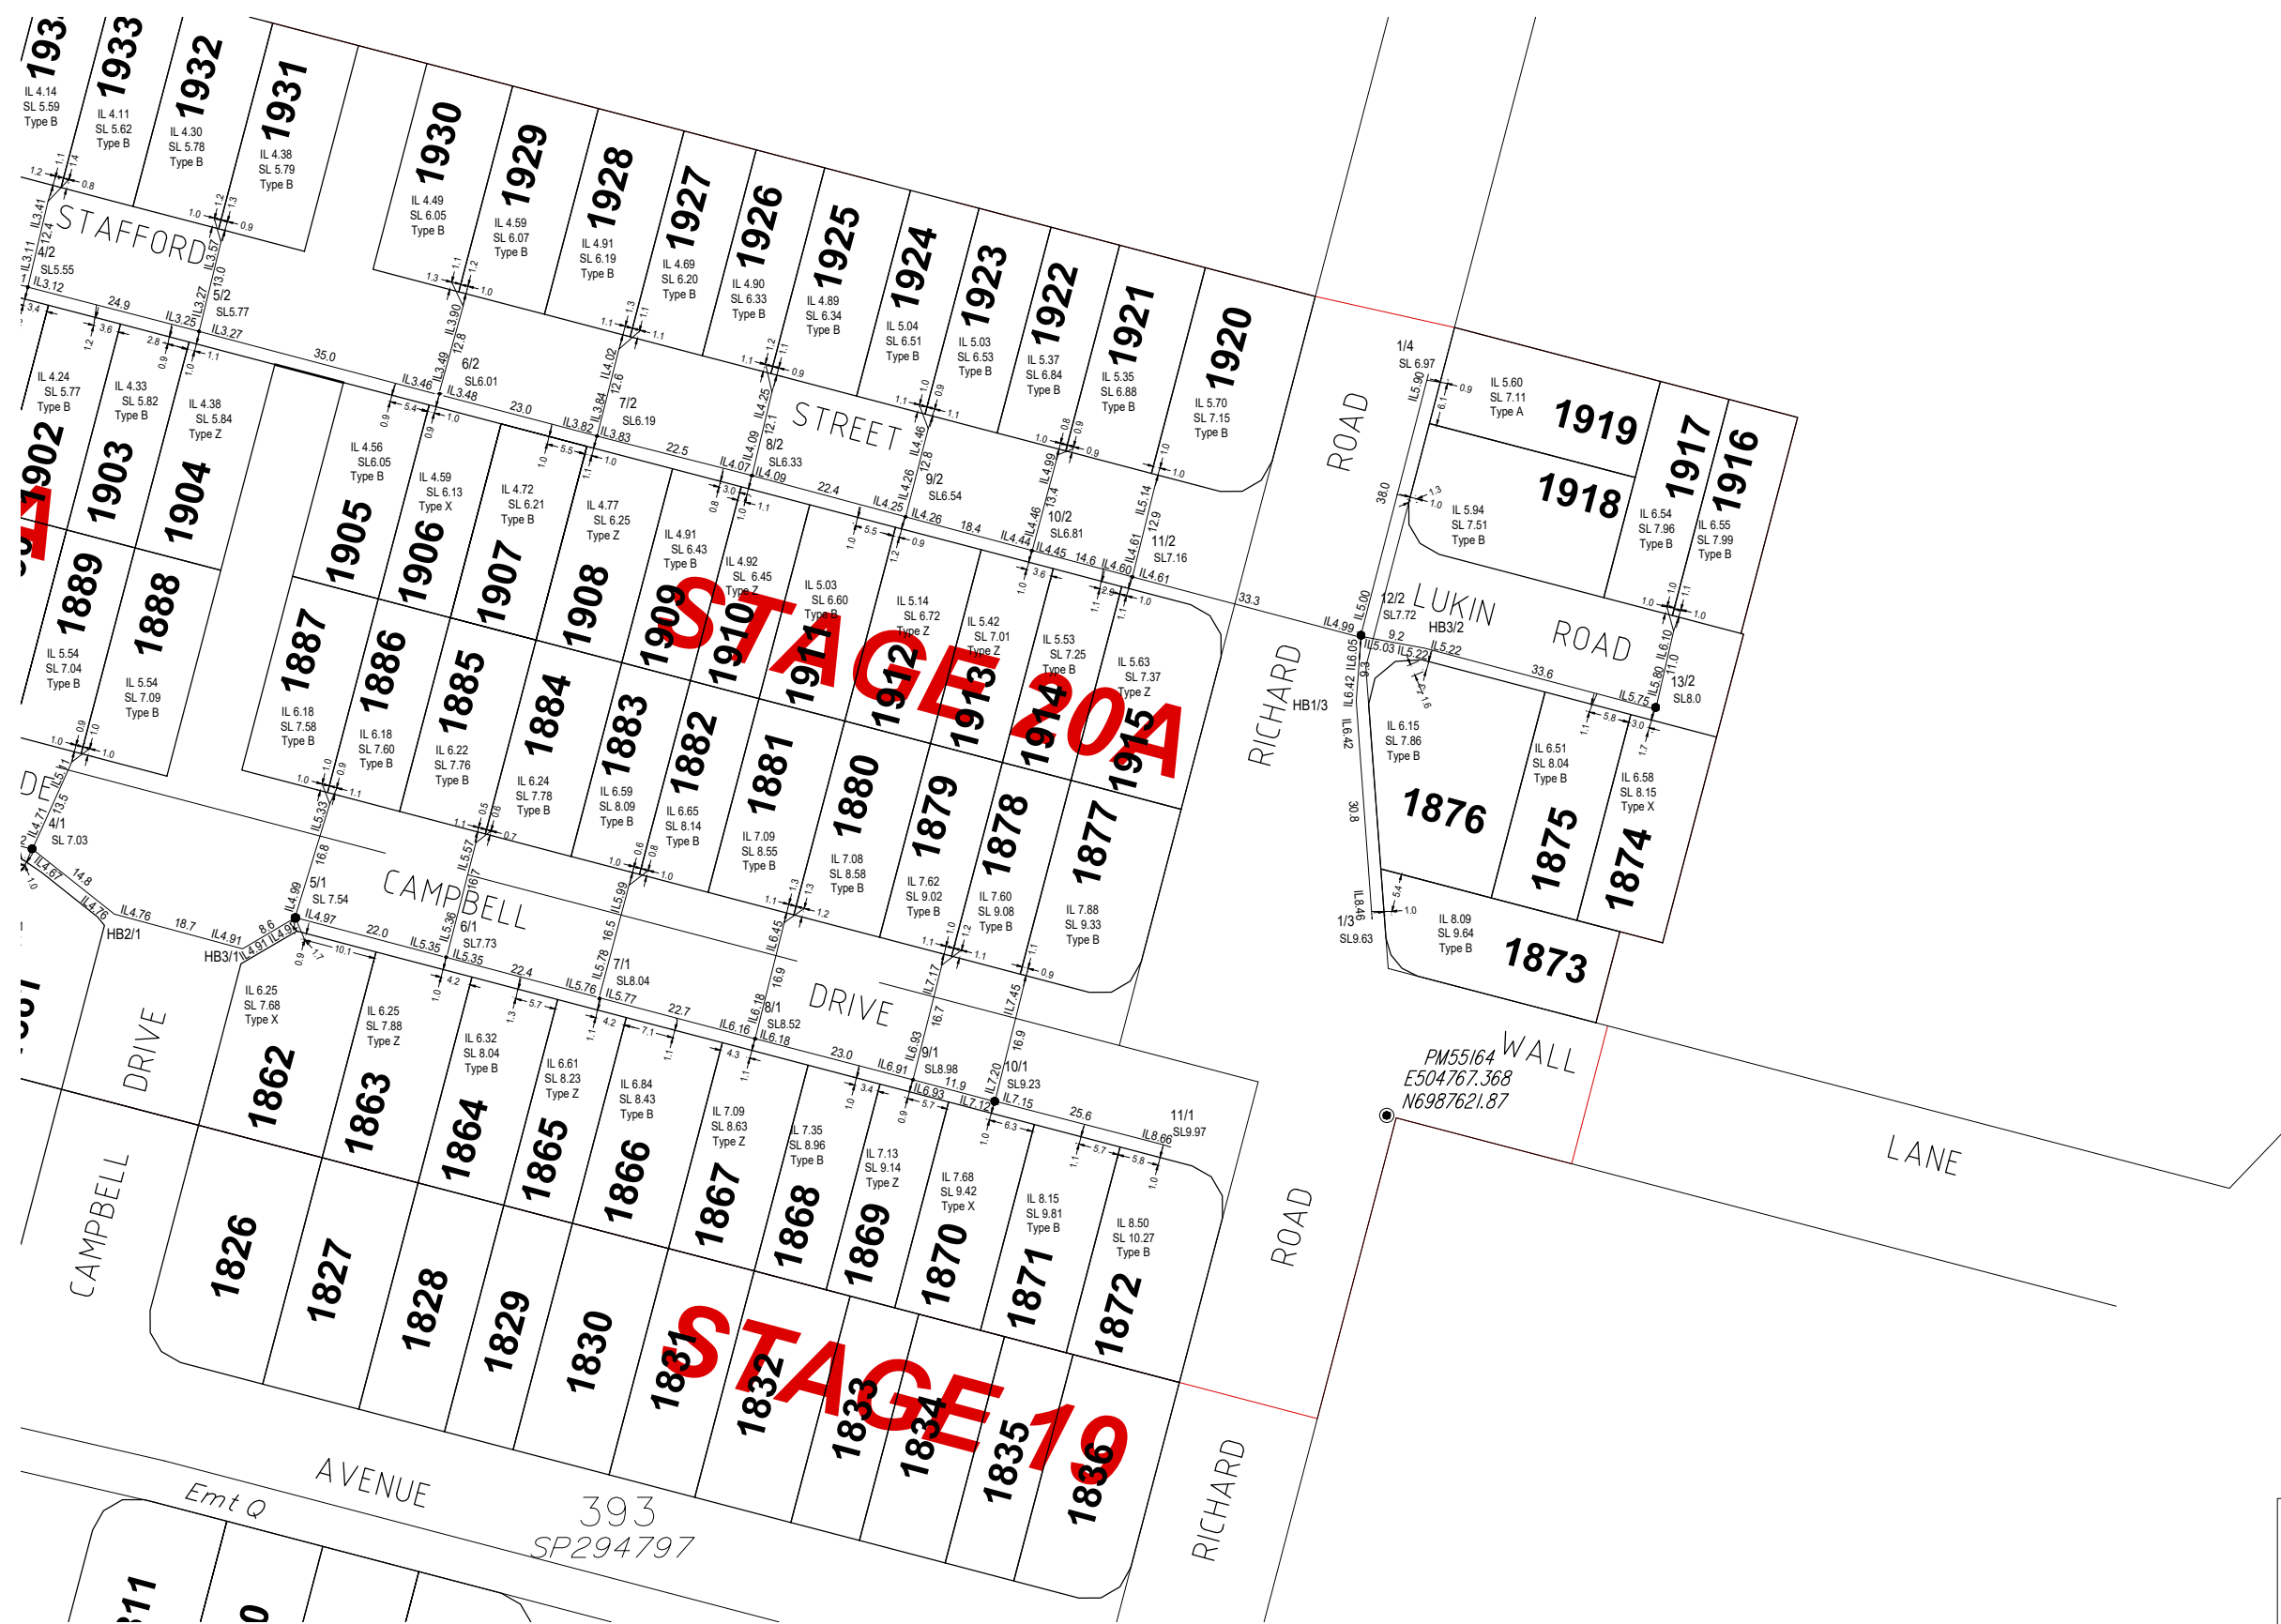

Registered Surveyor's certification
 We, QUEENSLAND SURVEYING PTY LTD, hereby certify that the vertical and horizontal locations, and dimensions shown on this plan are a true and correct record and were located by survey.

[Signature] 6152 21/06/2018
 Delegate Cadastral Surveyor Date

- NOTES:**
- All new mains DWE50 PVC-U S100 unless noted otherwise.
 - All property connections are DWE90 PVC-U

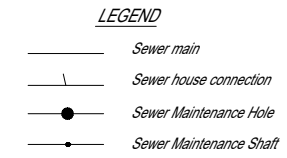

COORDINATE DATUM NOTE:
 HORIZONTAL COORDINATES(E,N) SUPPLIED ARE MAPPING GRID OF AUSTRALIA(MGA), ZONE 56 BASED ON THE UNIVERSAL TRANSVERSE MERCATOR PROJECTION AND THE GEOCENTRIC DATUM OF AUSTRALIA 1994.
 HORIZONTAL DATUM DERIVED FROM PSM186710, E 503315 600, N 6987236.028.
 LEVELS SUPPLIED ARE ON THE AUSTRALIAN HEIGHT DATUM(AHD)
 LEVEL DATUM DERIVED FROM PSM177891 RL 16.396 (AHD)

ENGINEER'S CERTIFICATION

* I, DARRYL HAYTER
 being a Consulting Engineer and duly authorised representative of: -
Empower Engineers & Project Managers
 hereby:-
 # certify the information contained in this drawing is an accurate "as constructed" representation of the works;
 # accept responsibility for the "as constructed" information contained in this drawing; and
 # acknowledge the "as constructed" information contained in the drawing may be relied on by the Moreton Bay Regional Council and others.
 Certification for Stage 20A by D.H. on 28/06/18
 For: Empower Engineers & Project Managers RPEQ 5694

A1	INDEX	DATE	REVISIONS	DRAWN	CHECKED	PASSED	INITIALS	DATE
	A	21/06/2018	ORIGINAL	JMc	JMc			
				DRAWN	CHECKED	PASSED		
				DRAWN	CHECKED	PASSED		

veris

BRISBANE 071 306 4320
 MACKAY 071 4051 2911
 PROSERPINE 071 4461 7122
 CAIRNS 071 4051 6722
 veris.com.au

ACN 804 671 374
 Queensland Surveying Pty Ltd a Veris Company



Unitywater

2017009844
 STAGE 20A CAPESTONE ESTATE
 KINSELLES ROAD EAST, MANGO HILL
 AS-CONSTRUCTED SEWER

SHEET 2 OF 2 SHEETS	SCALE 1:500
REVISION DATE 21/06/2018	REVISION A
DISCIPLINE CODE C	
DRAWING NO. U-2017-0408	