




# STAGE 11

# STAGE 12A

# STAGE 12B

Registered Surveyor's certification  
 We, VERIS AUSTRALIA Pty Ltd, hereby certify that the vertical and horizontal locations, and dimensions shown on this plan are a true and correct record and were located by survey.

*[Signature]* 6448 08/08/2018  
 Delegate Cadastral Surveyor Date

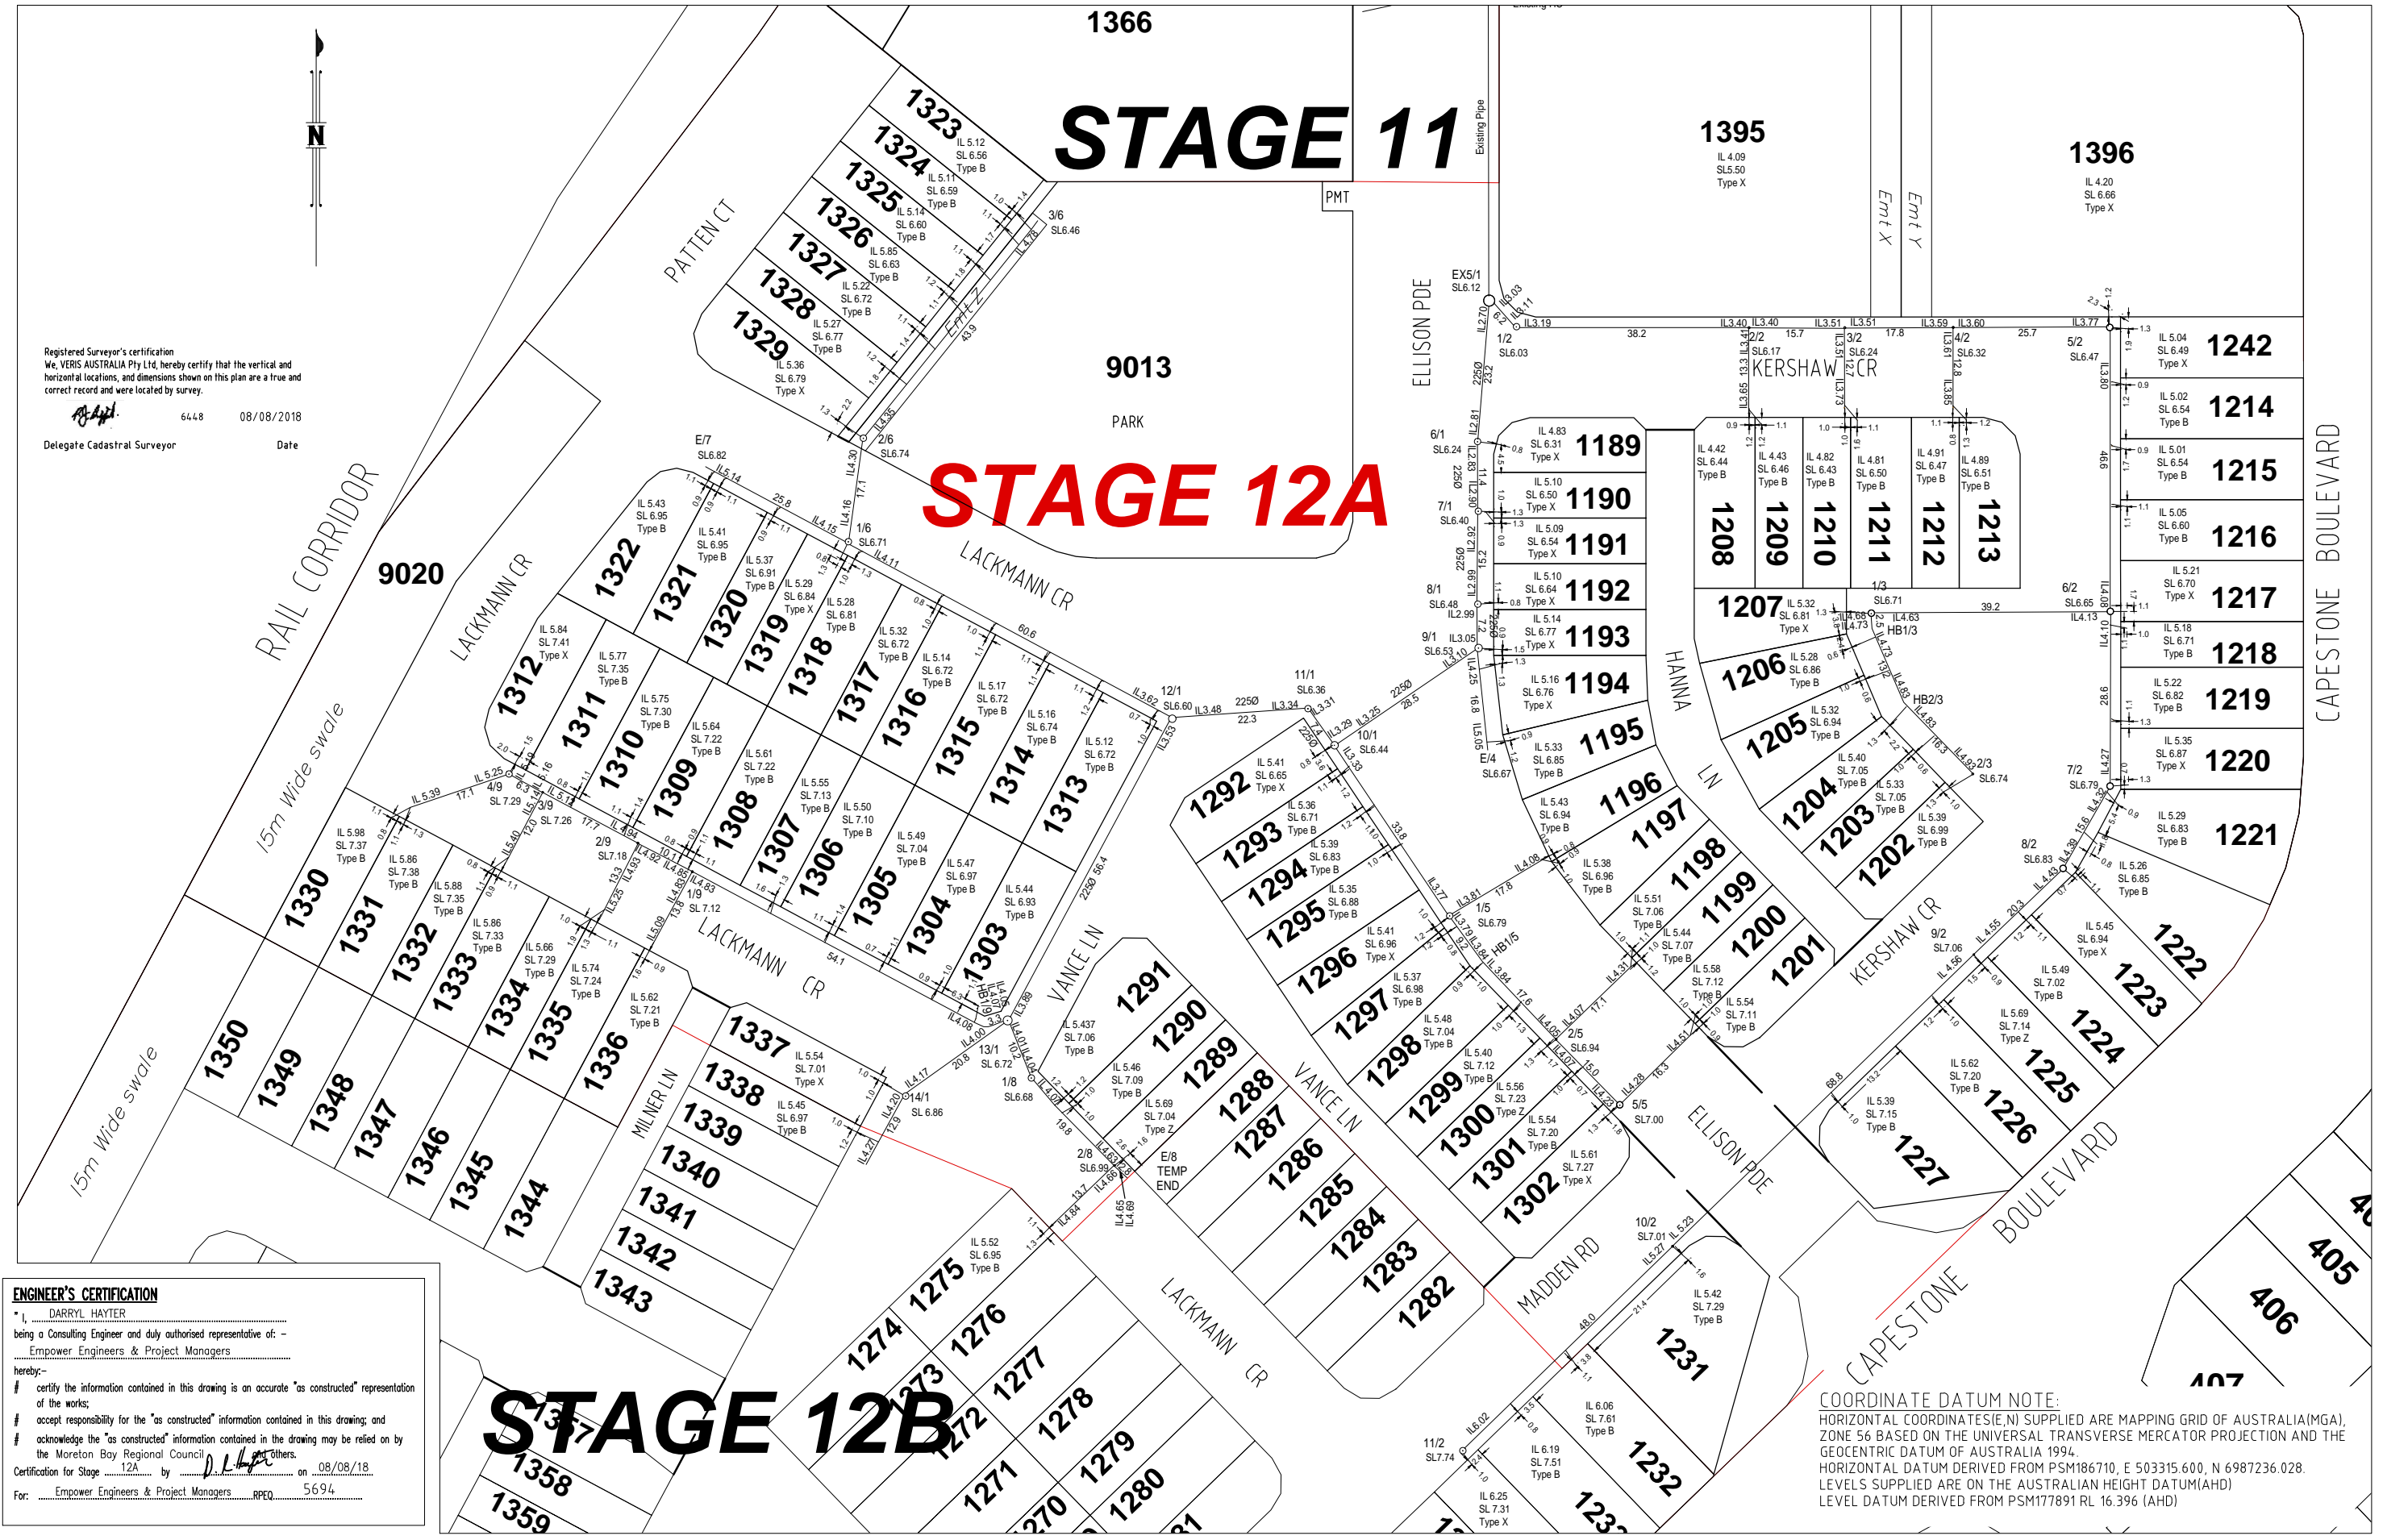

**ENGINEER'S CERTIFICATION**  
 I, DARRYL HAYTER  
 being a Consulting Engineer and duly authorised representative of: -  
 Empower Engineers & Project Managers  
 hereby:-  
 # certify the information contained in this drawing is an accurate "as constructed" representation of the works;  
 # accept responsibility for the "as constructed" information contained in this drawing; and  
 # acknowledge the "as constructed" information contained in the drawing may be relied on by the Moreton Bay Regional Council and others.  
 Certification for Stage 12A by D.H. on 08/08/18  
 For: Empower Engineers & Project Managers RPEQ 5694

**COORDINATE DATUM NOTE:**  
 HORIZONTAL COORDINATES(E,N) SUPPLIED ARE MAPPING GRID OF AUSTRALIA(MGA), ZONE 56 BASED ON THE UNIVERSAL TRANSVERSE MERCATOR PROJECTION AND THE GEOCENTRIC DATUM OF AUSTRALIA 1994.  
 HORIZONTAL DATUM DERIVED FROM PSM186710, E 503315 600, N 6987236.028.  
 LEVELS SUPPLIED ARE ON THE AUSTRALIAN HEIGHT DATUM(AHD)  
 LEVEL DATUM DERIVED FROM PSM177891 RL 16.396 (AHD)

A1	B	08/08/2018	Add missing HCs	EJM	EJM				
	A	27/07/2018	ORIGINAL	JMc	JMc	PASSED			
	INDEX	DATE	REVISIONS	DRAWN	CHECKED	PASSED	INITIALS	DATE	

**veris**  
 BRISBANE 09 308 4300  
 MACKAY 07 4651 2011  
 PROSERPINE 09 4961 1232  
 CAIRNS 07 4651 8722  
 veris.com.au  
 ACN 604 671 374  
 Queensland Surveying Pty Ltd & Veris Company



**Unitywater**  
 201701524  
 STAGE 12A CAPESTONE ESTATE  
 KINSSELLES ROAD EAST, MANGO HILL  
 AS-CONSTRUCTED SEWER

SHEET 1 OF 2 SHEETS	SCALE 1500
REVISION DATE 08/08/2018	REVISION B
DISCIPLINE CODE C	
DRAWING NO. U-2018-0555 AS	